




SKWB9180435354.564  
NO.

THREE PHASE TRANSFORMER




SUNBELT TRANSFORMER  
TEMPLE, TEXAS

KVA 300  
HV 4160  
WT TANK 1125 C&C 1167 OIL 1321 LBS  
LB 176 GAL TOTAL 3613 LBS

2.0 %IMP BIL HV 60 LV 30KV  
LV 208Y/120 AMPS 833

CONT 65 °C RISE CLASS ONAN 60HZ  
TANK DESIGNED FOR +7 PSIG  
F1 ISOLATION LINK  
F2 BAYONET FUSE

CONTAINS NO DETECTABLE LEVEL OF PCB (LESS THAN 2 PPM) AT THE TIME OF MANUFACTURE.

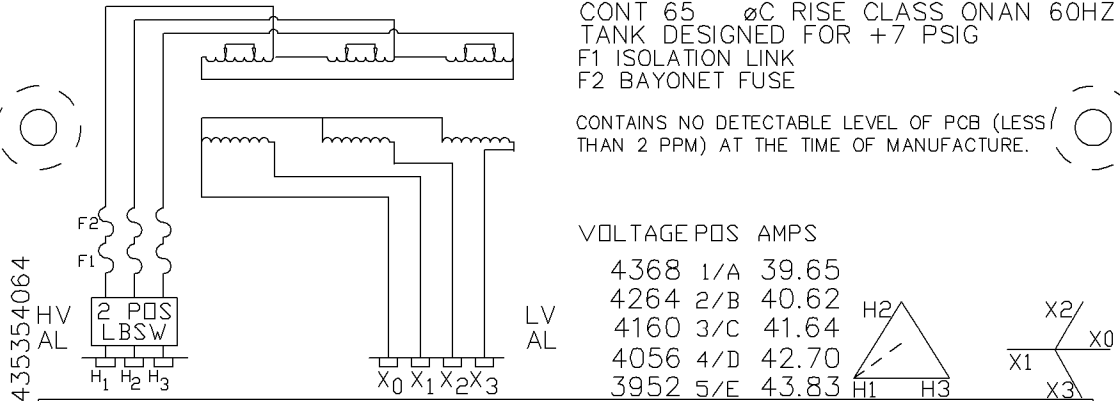


VOLTAGE POS AMPS

4368	1/A	39.65
4264	2/B	40.62
4160	3/C	41.64
4056	4/D	42.70
3952	5/E	43.83

9180435354064  
SER. NO. BAR CODE CAT. NO. BAR CODE  
SER. NO.

BLACK ANNODIZED ALUMINUM

RECORD DRAWING

					 <p>SUNBELT TRANSFORMER TEMPLE, TEXAS</p>	
						NAME: LASER NAME PLATE CC 857
						DESCR: RF/TP/2FUSE/2PLB/ D-Y
						ID 3BCW4336 P.N. SKWB9180435354.564
						SCALE 1.000 DWG BY WB CHK BY DATE 07/15/03
REV	DATE	REVISION	BY	APP		